


N/F
354 LOWELL STREET
PARCEL ID: 026.0-0000-0098.0

N/F
DICENZO, TOWN OF READING
PARCEL ID: 026.0-0000-0097.0

BORDERING VEGETATED
WETLANDS DELINEATED BY
SEAKAMP ENVIRONMENTAL,
INC. ON DECEMBER 26, 2020

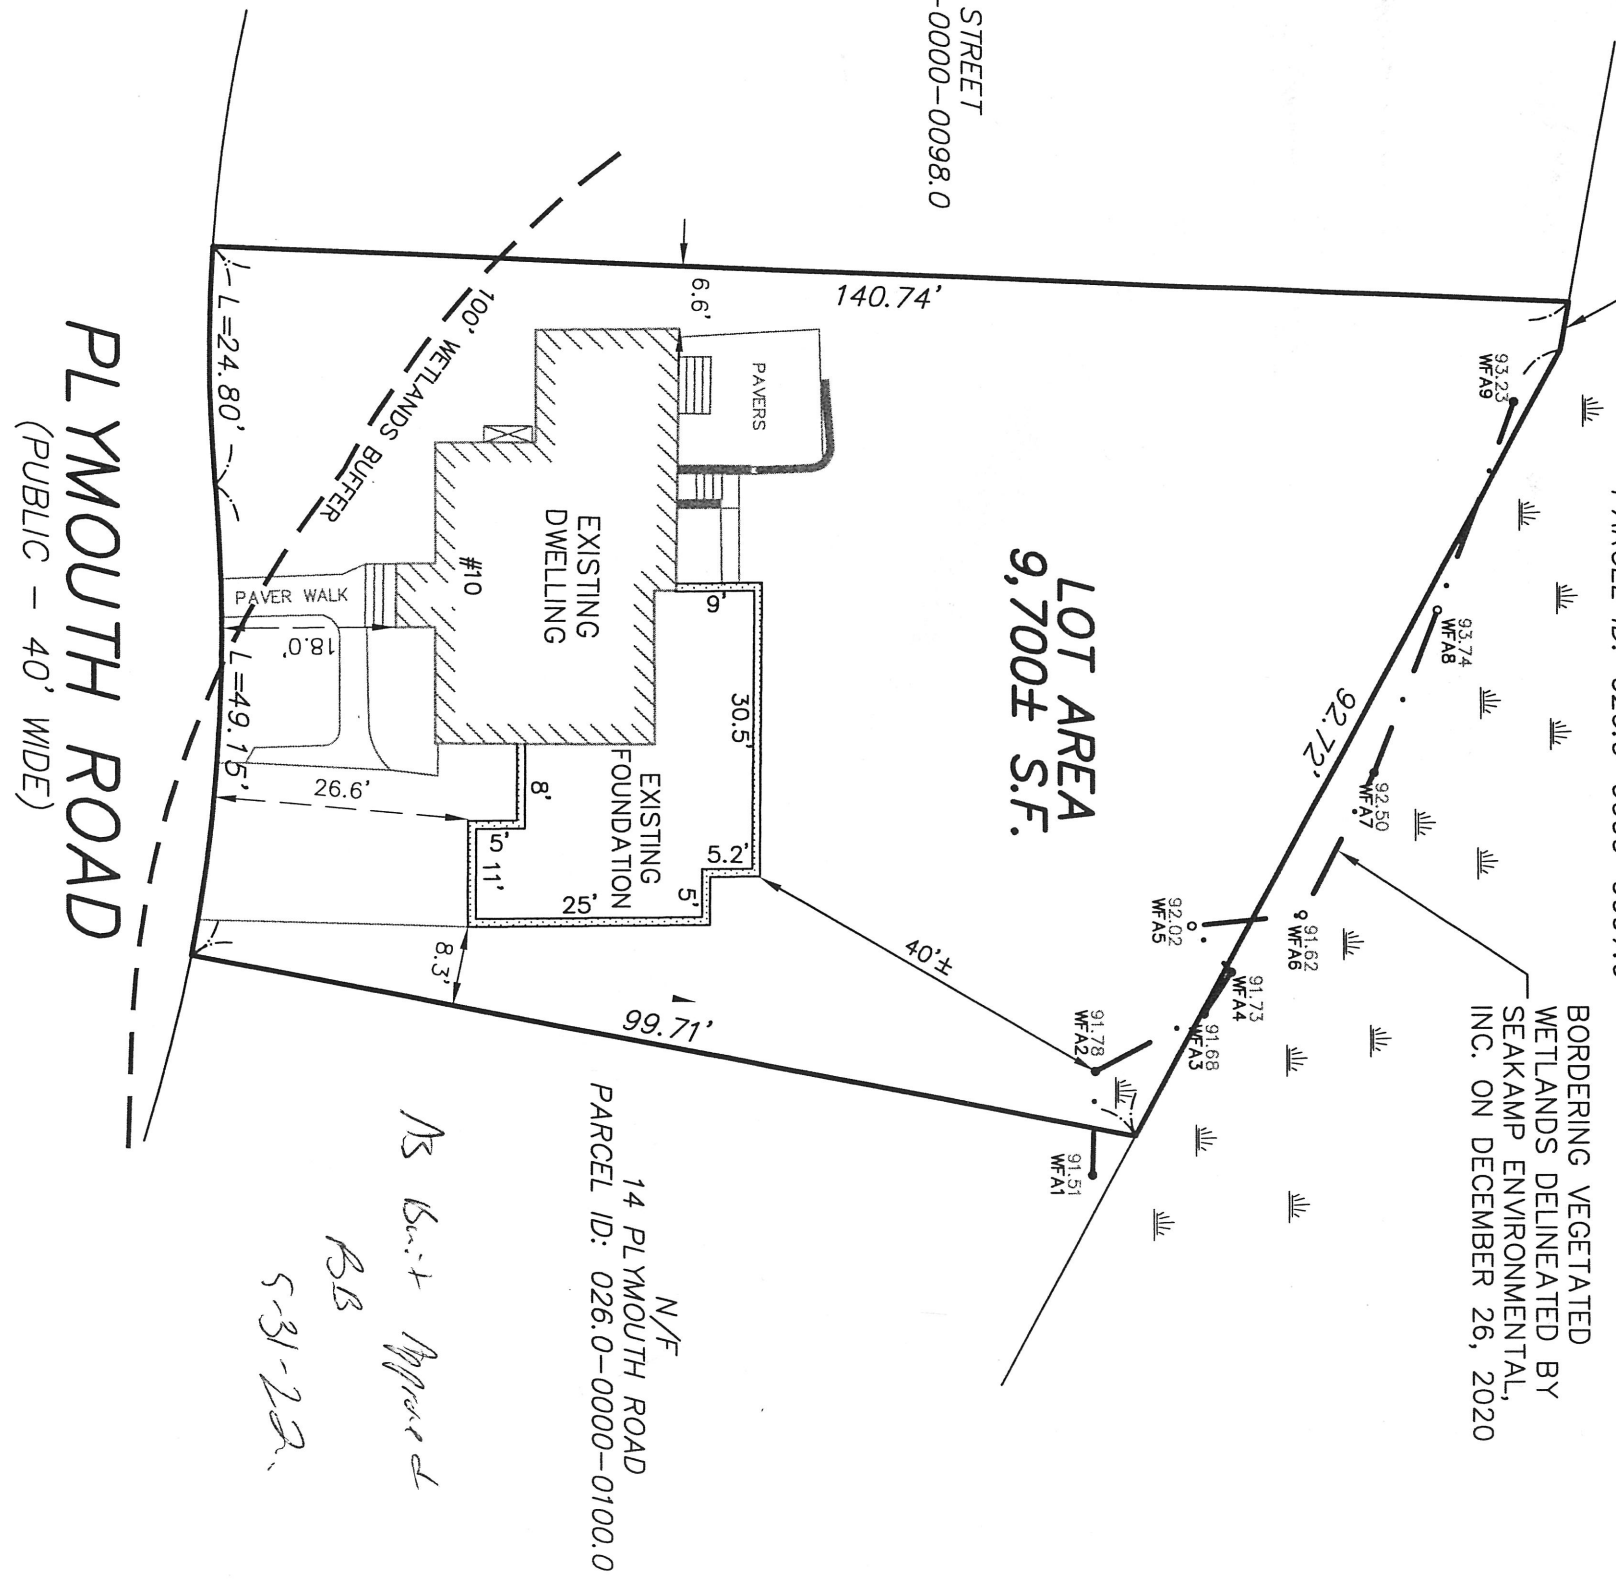


N/F
14 PLYMOUTH ROAD
PARCEL ID: 026.0-0000-0100.0

*As Built Approved
BB
5-31-22*

PLYMOUTH ROAD
(PUBLIC - 40' WIDE)

RECORD OWNER:
COLIN L. & JUDITH MCKINNON
BOOK 44557 PAGE 207
PLAN REFERENCE:
LOT 1 ON END OF 6587

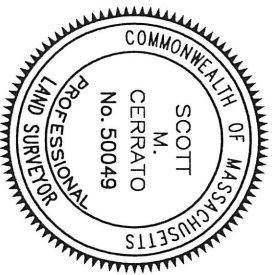

I HEREBY CERTIFY THAT THIS PLAN IS BASED
ON AN ACTUAL INSTRUMENT SURVEY MADE ON THE
GROUND IN MAY 2022 AND THE FOUNDATION
DEPICTED HEREON IS LOCATED AS SHOWN.

5-30-22
DATE SIGNATURE



SCOTT M. CERRATO
Professional Land Surveyor
24 Pleasant View Drive - Exeter, NH 03833 - 781-775-3724

AS-BUILT PLOT PLAN
10 PLYMOUTH ROAD
READING, MASSACHUSETTS
PARCEL ID: 026.0-0000-0099.0

MAY 30, 2022