

LEGEND:

- 5A = WETLAND FLAG
- = WETLAND AREA
- 99x0 = SPOT GRADE
- FFE = FIRST FLOOR ELEVATION
- = UTILITY POLE

ZONING INFORMATION:

ZONING DISTRICT : S-15
 MIN. BLDG. SETBACKS:
 FRONT : 20 FEET
 SIDE : 15 FEET
 REAR : 20 FEET

OWNER INFORMATION:

CJM BUILDERS, INC.
 126 MAIN STREET, UNIT 5
 NORTH READING, MA 01864


DEED INFORMATION:

BOOK: 81443 PAGE: 203

ASSESSOR INFORMATION:

MAP 39 PARCEL 33

Note:
 Wetland Delineation performed
 by Norse Environmental Services
 on 3/30/2023

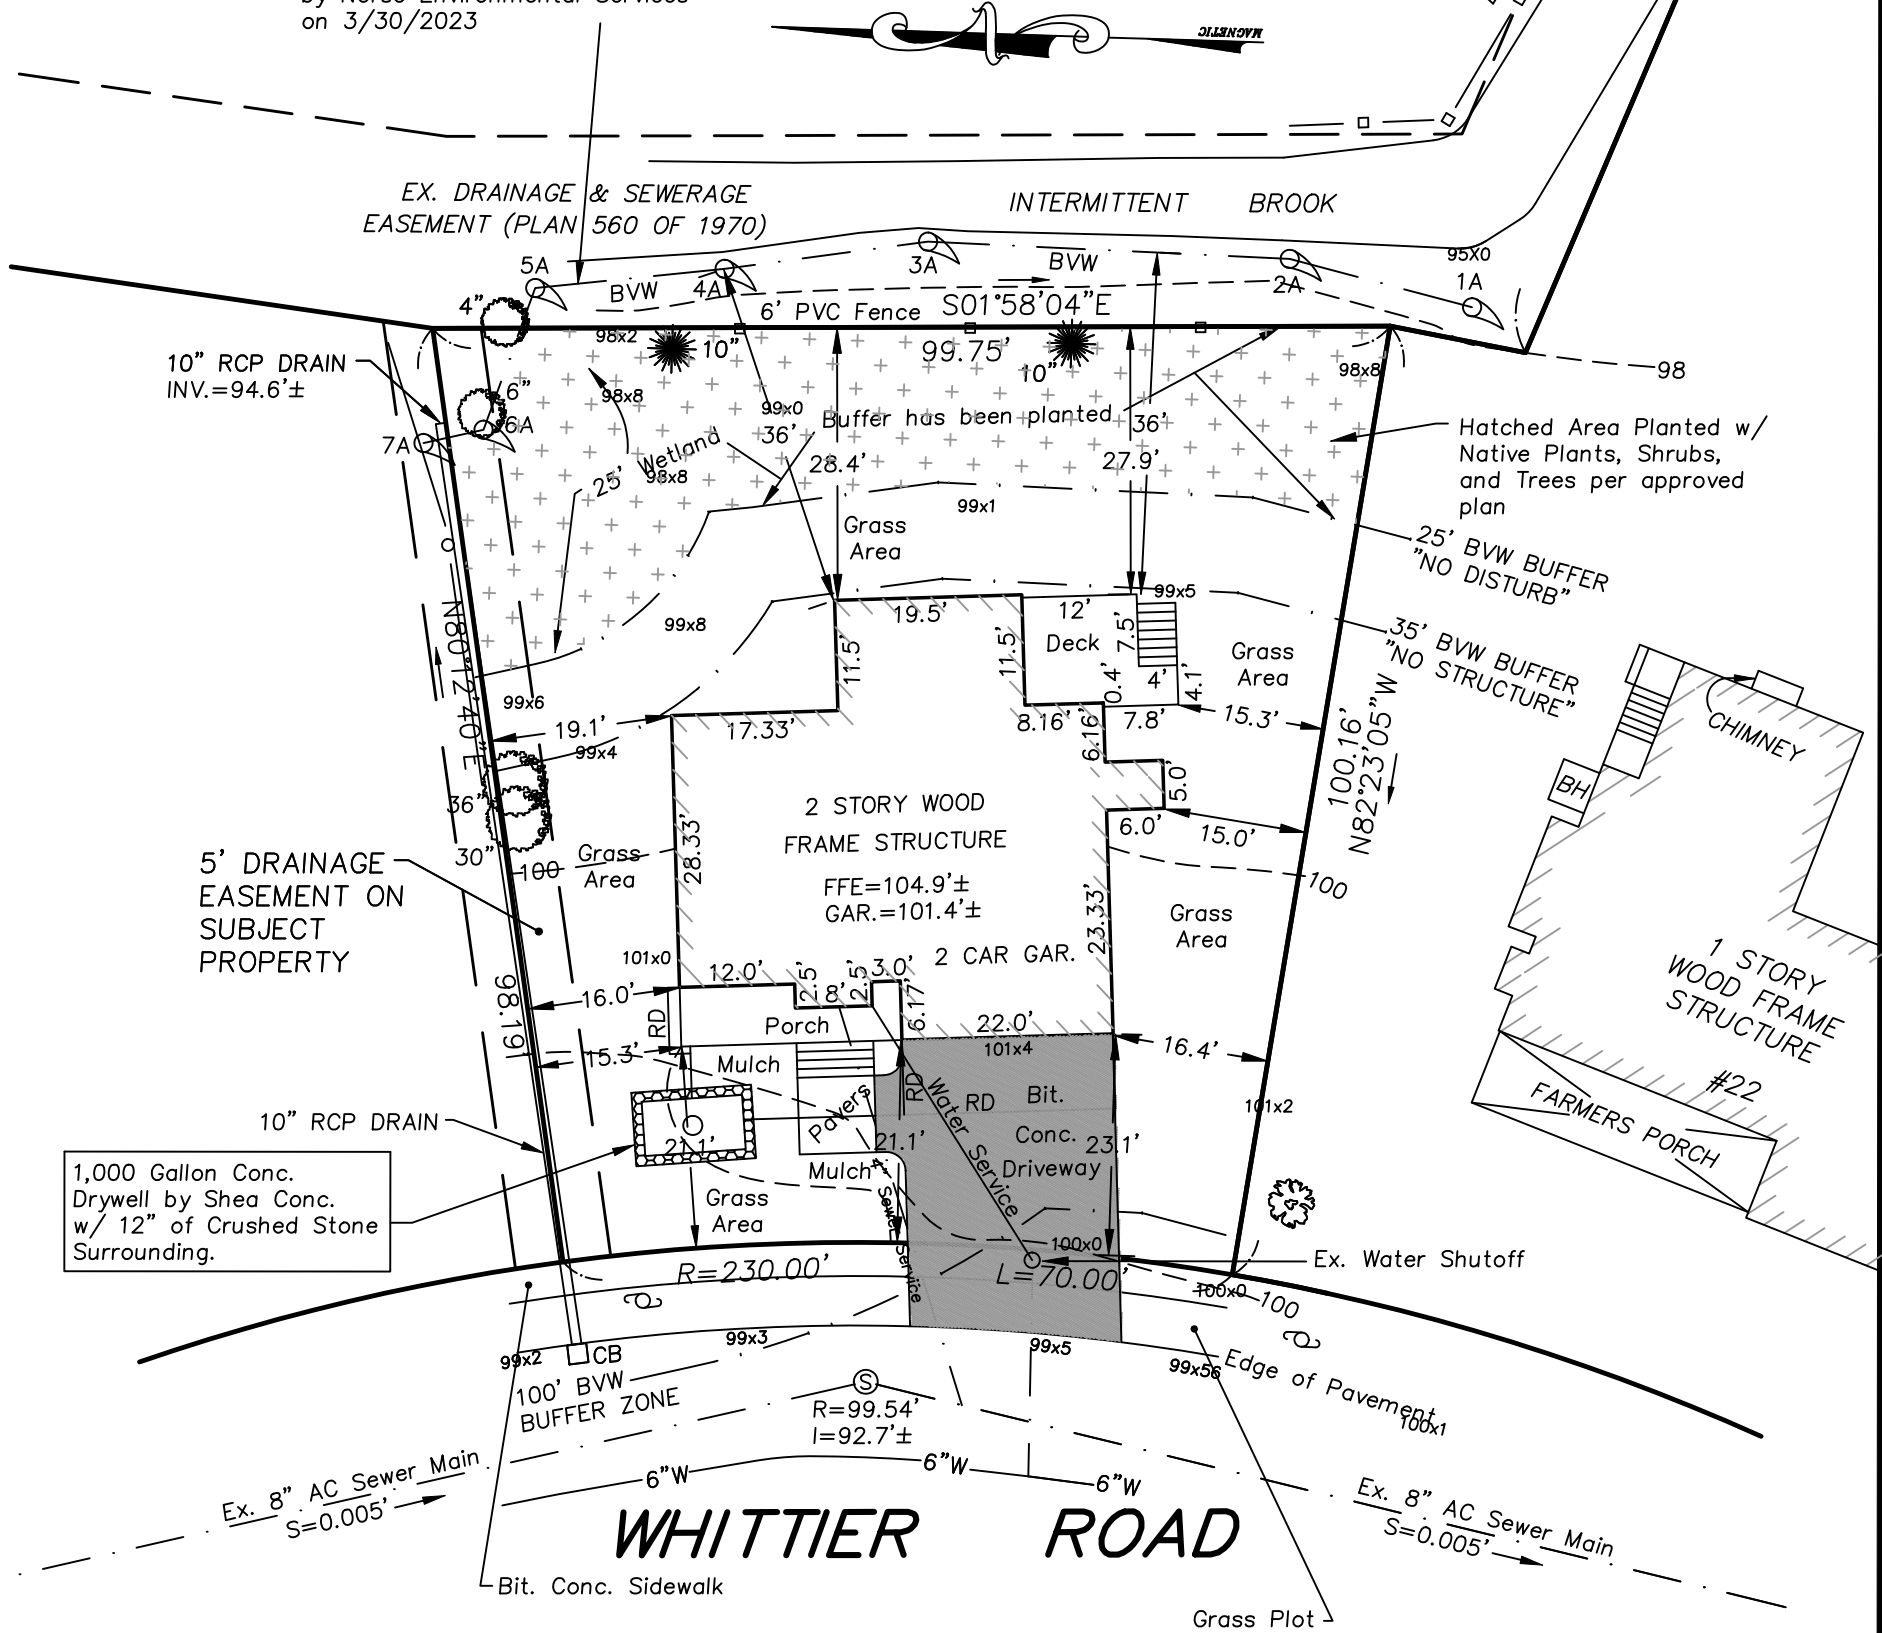

DEP FILE #:
 270-0771

AS-BUILT PLAN
#18 WHITTIER ROAD
 READING, MA 01867
 PREPARED BY:
 JOHN D. SULLIVAN III, P.E.
 P.O. BOX 2004
 WOBURN, MA 01888
 (781) 854-8644
 SCALE: 1"=20' DATE: 6/5/24

