

LEGEND:

- 96x7

SPOT GRADE
- BIT.

BITUMINOUS
- 

TREELINE
- 

WETLAND RESOURCE AREA
-  1A

WETLAND FLAG NUMBER

Plant Legend			
Symbol	Qty	Common	Botanical
	3	American Cranberry Bush	Viburnum trilobum
	1	CANADIAN HEMLOCK	Tsuga canadensis
	1	EASTERN REDBUD	Cercis canadensis
	5	HIGHBUSH BLUEBERRY	Vaccinium corymbosum
	3	RED-OSIER DOGWOOD	Cornus stolonifera

Note:
Wetland Delineation Performed by
Norse Environmental Services Inc
in April of 2020.

- (3) RED-OSIER DOGWOOD
- (3) AMERICAN CRANBERRY BUSH
- 25' BVW BUFFER ZONE "NO DISTURB"
- 35' BVW BUFFER ZONE "NO STRUCTURE"
- (1) EASTERN REDBUD
- (5) HIGHBUSH BLUEBERRY
- (1) CANADIAN HEMLOCK

ZONING INFORMATION:

ZONING DISTRICT : S-20
MIN. BLDG. SETBACKS:
FRONT : 20 FEET
SIDE : 15 FEET
REAR : 20 FEET

ASSESSOR INFORMATION:

MAP 44 PARCEL 12

DEED REFERENCE:

BOOK: 35149 PAGE: 19


OWNER INFORMATION:

JOSEPH CICCARIELLO
48 PASTURE ROAD
READING, MA 01867

PROPOSED TREE REMOVAL
& RE-PLANTING PLAN
11/19/21

Ciccariello Residence
48 Pasture Rd.
Reading, Ma 01867

DiCicco Landscape (978) 646-0061

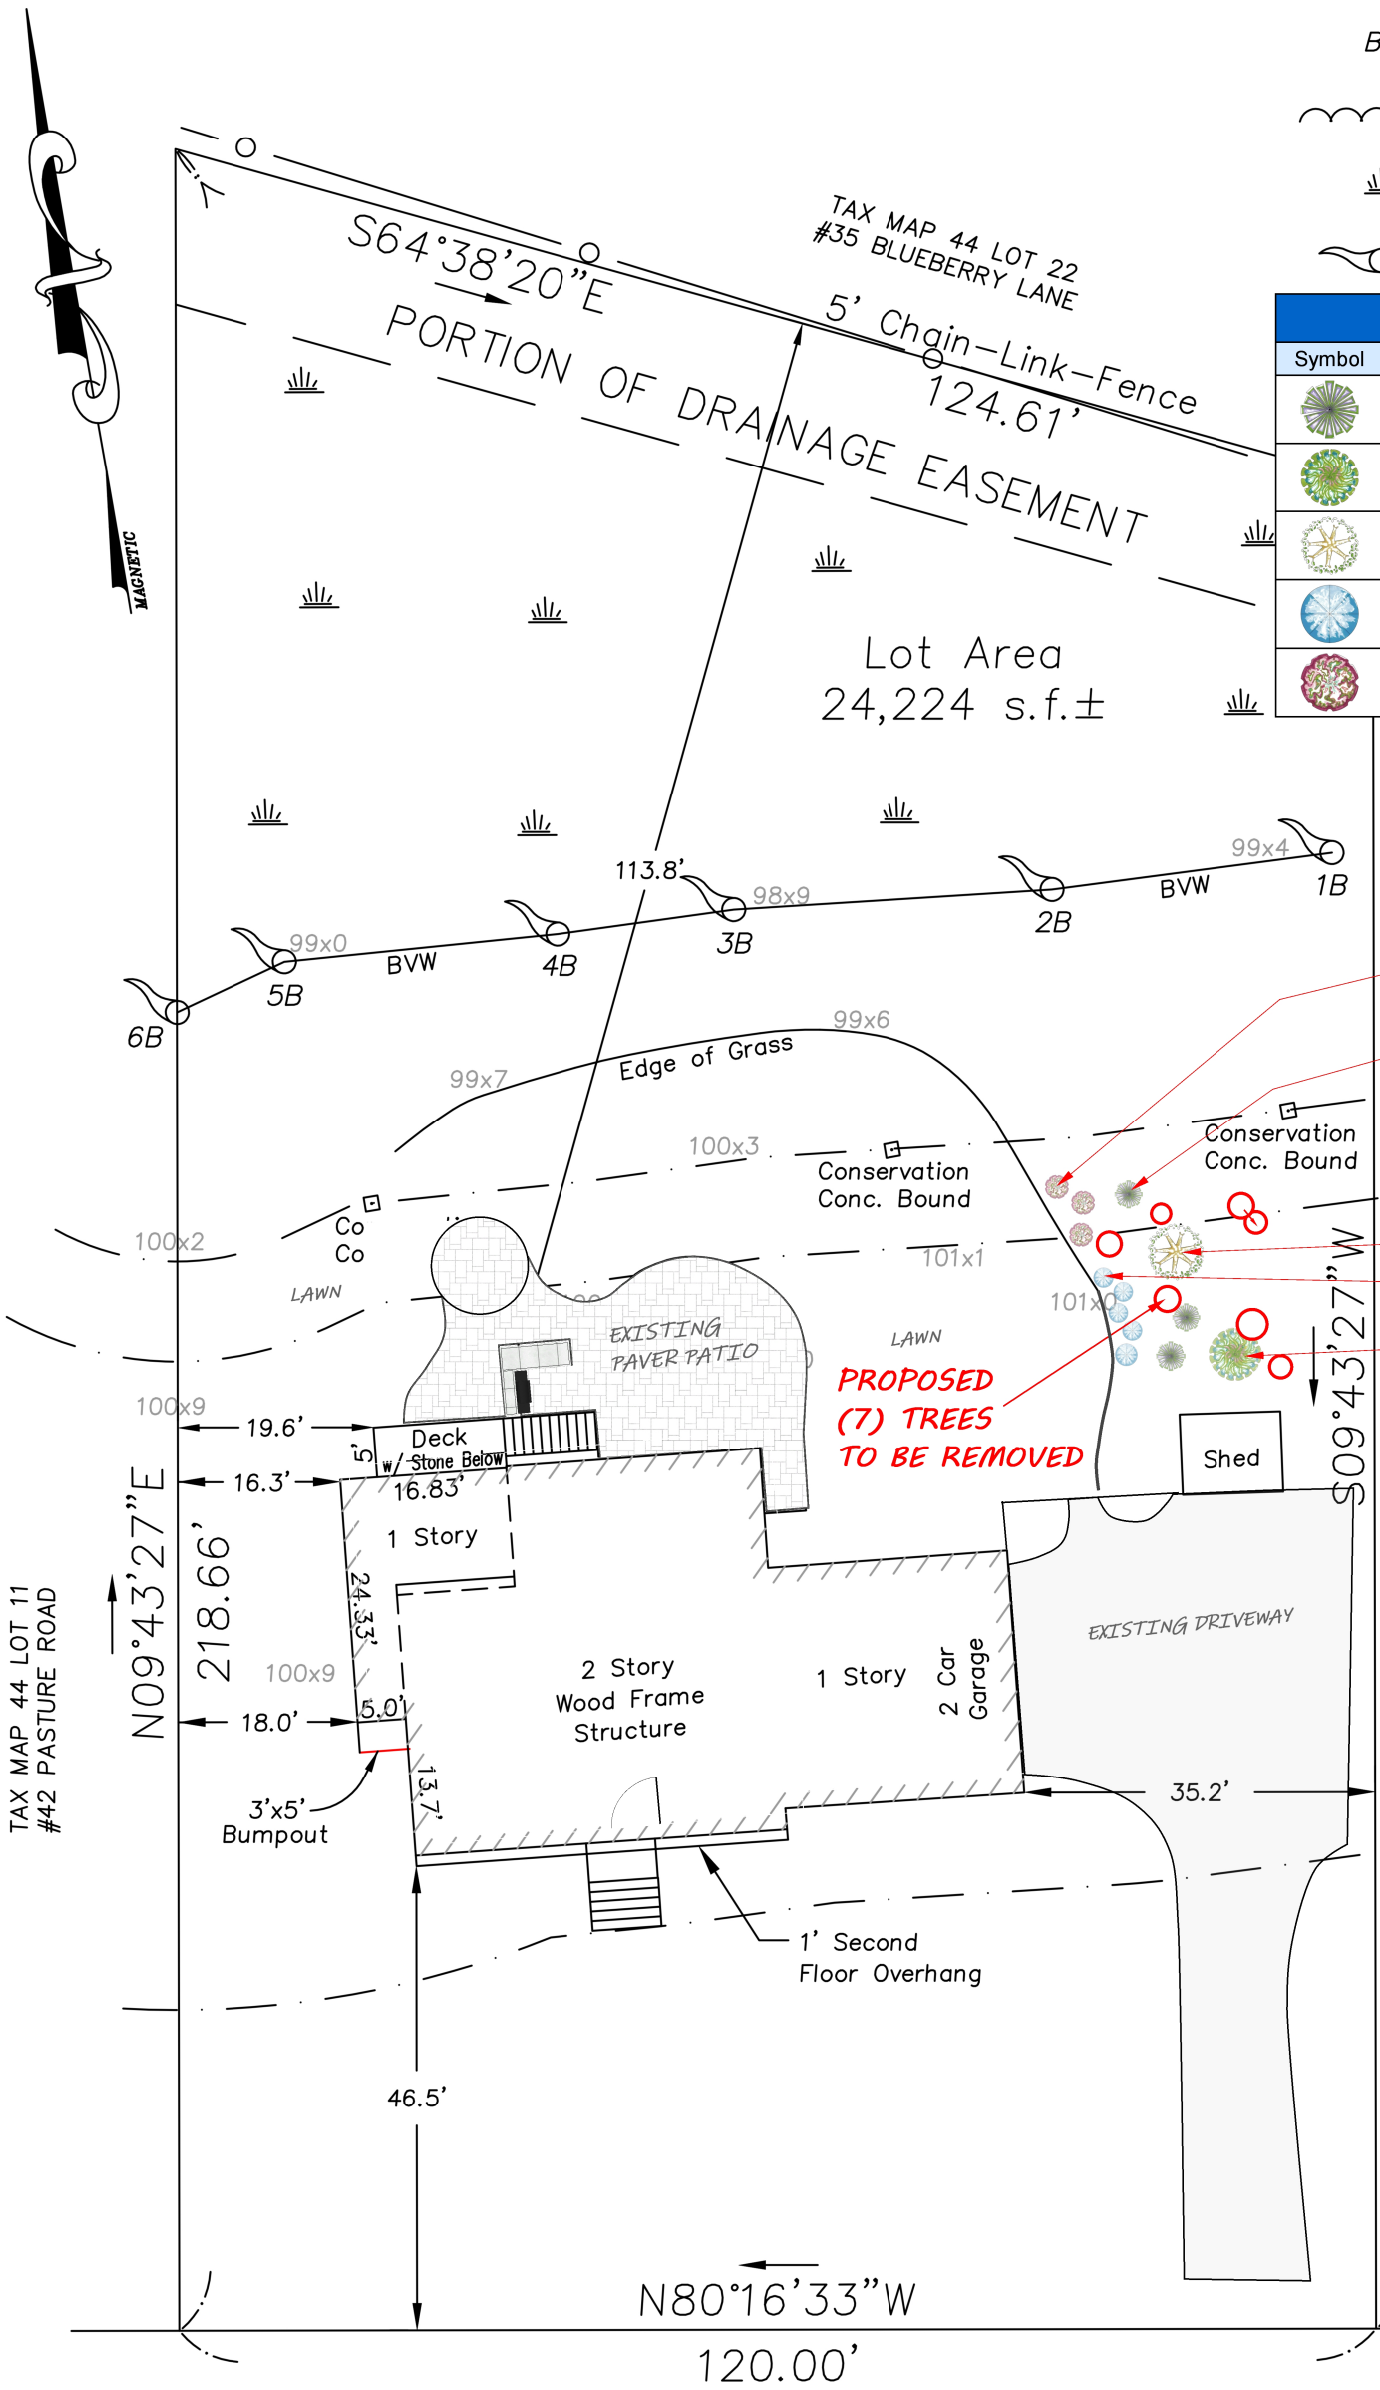

PASTURE

ROAD



AS-BUILT PLAN
#48 PASTURE ROAD
READING, MA 01867

PREPARED BY:
SULLIVAN ENGINEERING GROUP, LLC
P.O. BOX 2004
WOBURN, MA 01888
(781) 854-8644

DATE: 3/9/21 SCALE: 1"=20'