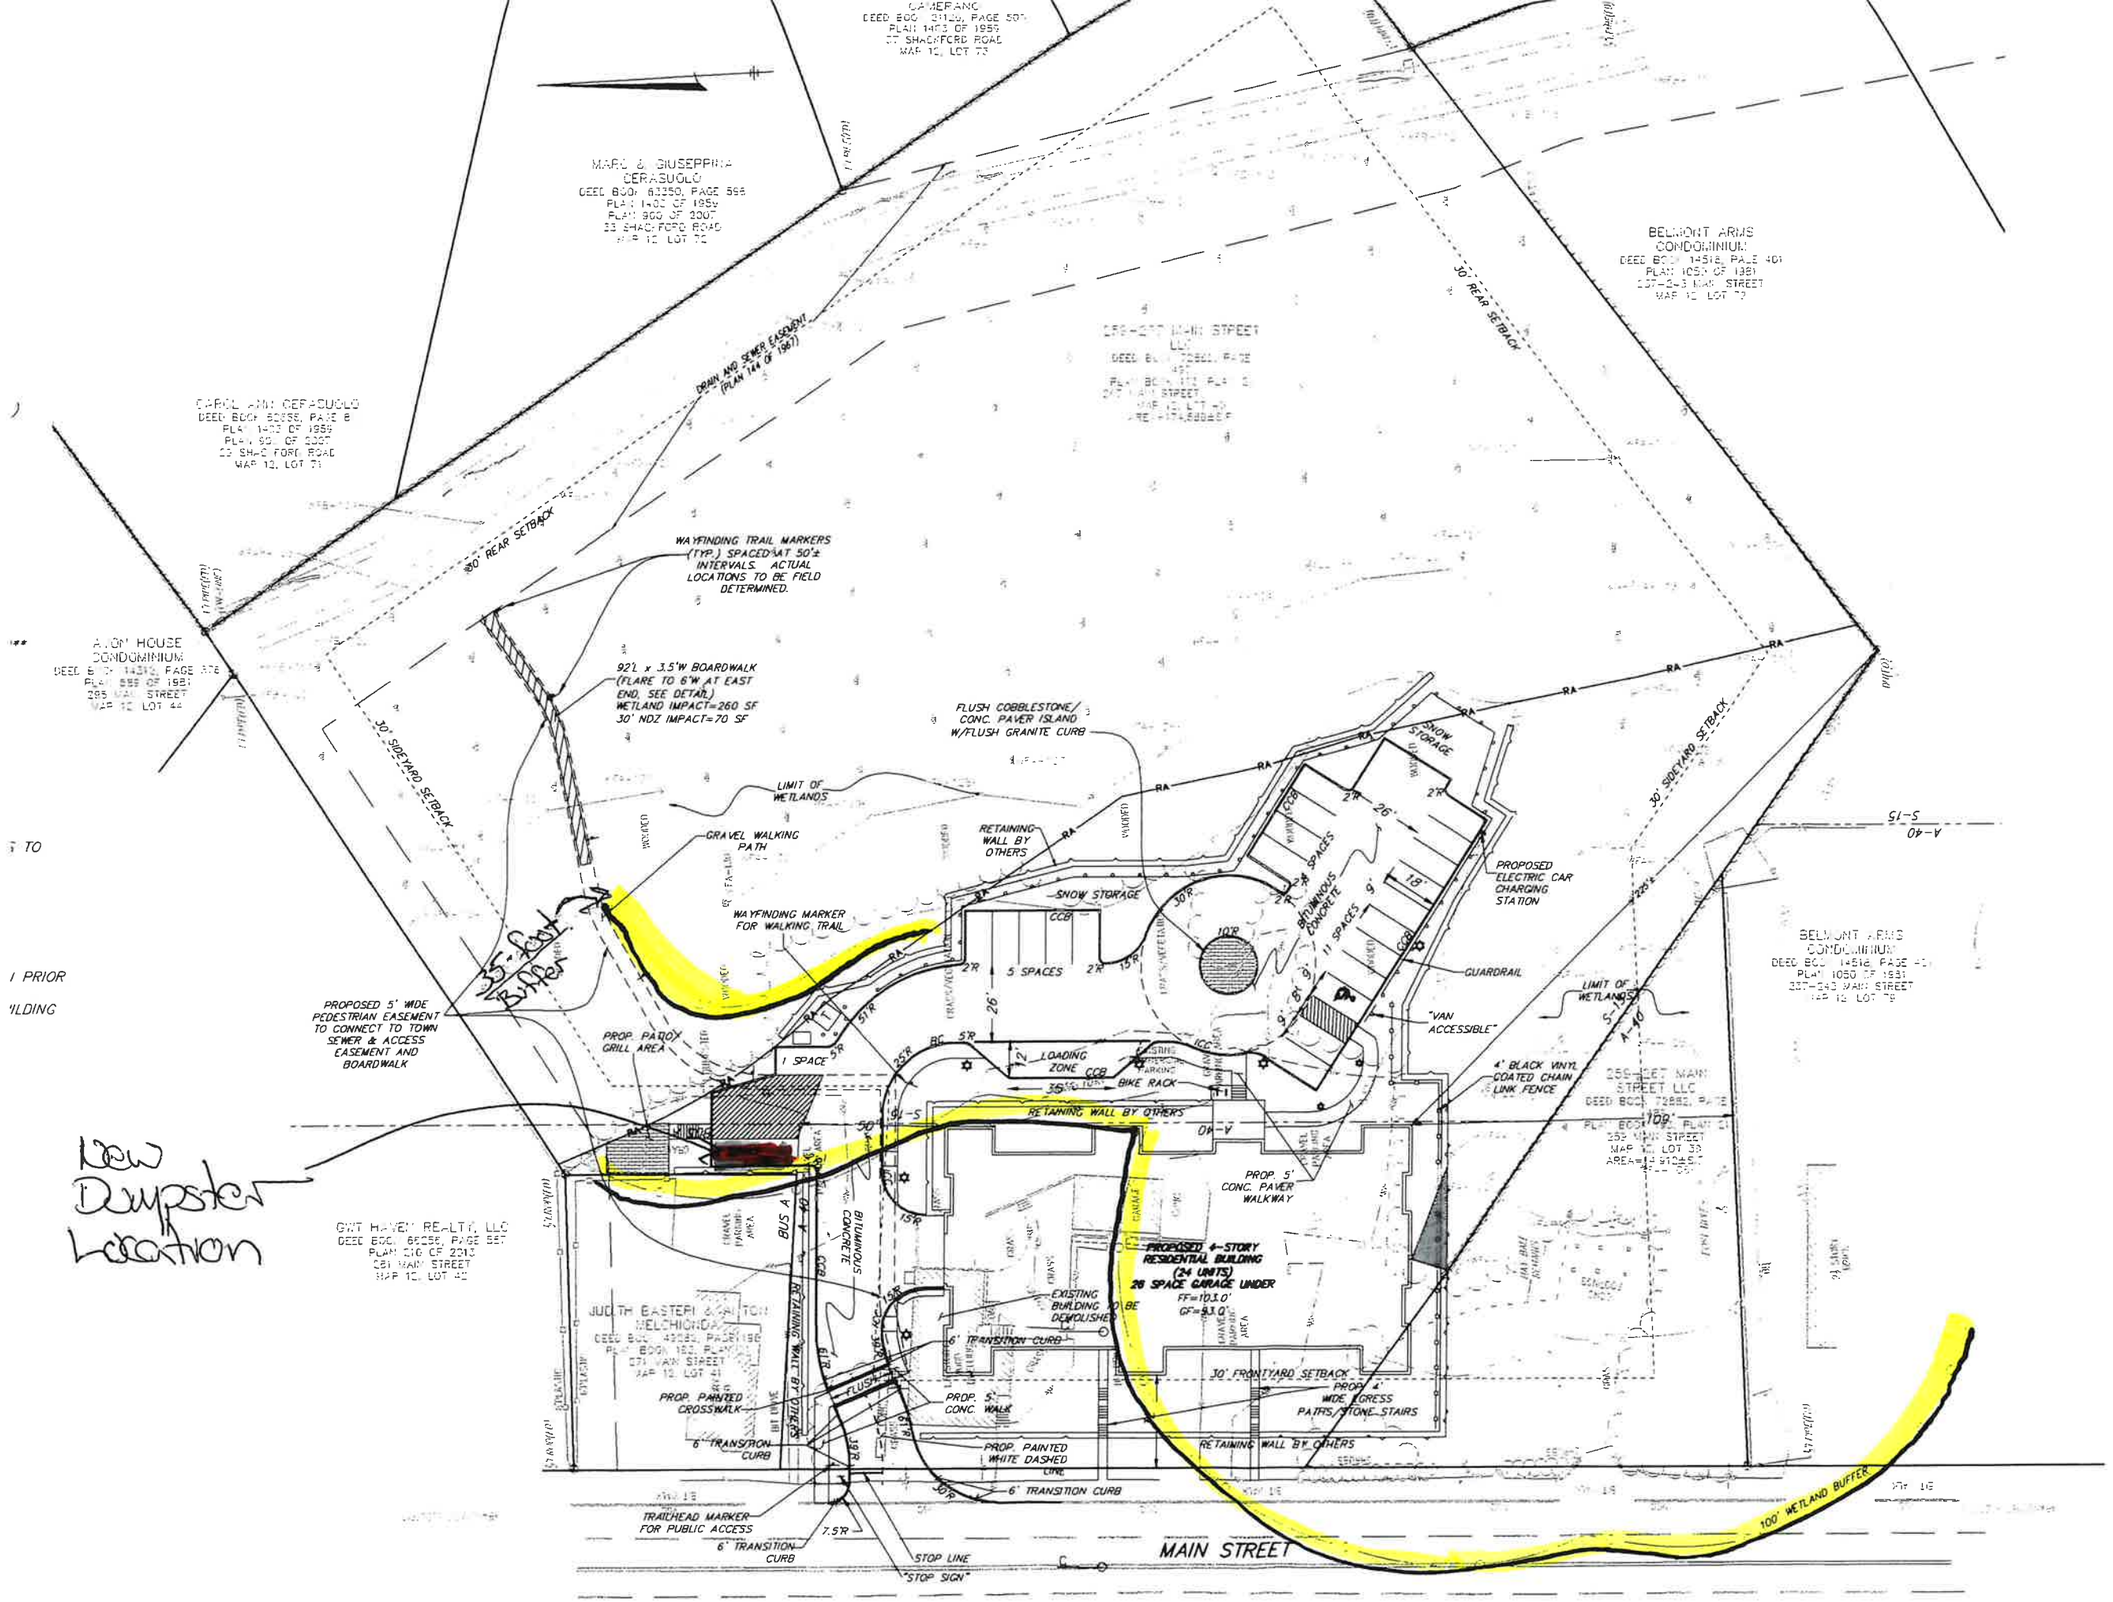

PLAN

259 & 267 Main Street
Reading, Massachusetts 01867

ASSESSORS:

MAP	PARCEL
12	39 & 40

PREPARED FOR:

Stonegate Construction Corp.

273 Corporate Drive, Suite 150
Portsmouth, New Hampshire 03801

HANCOCK ASSOCIATES

Civil Engineers

Land Surveyors

Wetland Scientists

185 CENTRE STREET, DANVERS, MA 01923
VOICE (978) 777-3050, FAX (978) 774-7816
WWW.HANCOCKASSOCIATES.COM

COMMONWEALTH OF MASSACHUSETTS
JOSEPH D. PEZNOLA
CIVIL
No. 38117
REGISTERED PROFESSIONAL ENGINEER

NO.	BY	APP	DATE	ISSUE/REVISION DESCRIPTION
8.	DJR	JP	6/15/20	REV. PER CON COMM COMMENTS
7.	RLG	JP	5/20/20	REV. PER CON COMM COMMENTS
6.	RLG	JP	5/1/20	REV. PER CON COMM COMMENTS
5.	RLG	JP	2/26/20	REV. PER CPDC COMMENTS
4.	RLG	JP	2/10/20	REV. PER CPDC/ENG COMMENTS
3.	RLG	JP	1/29/20	REV. PER CPDC/ENG COMMENTS
2.	RLG	JP	12/30/19	REVISED PER RCC COMMENTS
1.	RLG	JP	12/2/19	ISSUED FOR SITE PLAN REVIEW

DATE:	10/8/19	DESIGN BY:	RLG
SCALE:		DRAWN BY	RLG
APPRVD. BY:		CHECK BY:	JP

LAYOUT AND